

DEPARTMENT: Public Works/Local Transportation

BY: Peter Rei
PHONE: 966-5356

RECOMMENDED ACTION AND JUSTIFICATION:

Adopt a Resolution Authorizing the Submission of the Functional Classification Road Change Request Form and Attachments, and Approval of the Requested Road Reclassifications.

Staff recommends the reclassification of Bullion Street and Woodland Drive from Local to a Minor Collector due to the high Average Daily Traffic (ADT) counts and the connectivity each provides to other major collectors and highways. These reclassification changes will also allow the County to receive Federal funding for improvements.

BACKGROUND AND HISTORY OF BOARD ACTIONS

No previous Board actions.

*Original action
filed w/LTC
Res. 11-20*

ALTERNATIVES AND CONSEQUENCES OF NEGATIVE ACTION:

Not approve; risk relinquishing funding proposed for these roads.

Financial Impact? <input checked="" type="checkbox"/> Yes <input checked="" type="checkbox"/> No	Current FY Cost: \$	Annual Recurring Cost: \$
Budgeted In Current FY? <input checked="" type="checkbox"/> Yes <input type="checkbox"/> No <input type="checkbox"/> Partially Funded		
Amount in Budget: \$ 0		List Attachments, number pages consecutively
Additional Funding Needed: \$ 0		1. Functional Classification Change Request Form
Source:		2. Marked-up CRS maps
Internal Transfer _____		3. Resolution (LTC)
Unanticipated Revenue _____ 4/5's vote		4. Resolution (Board of Supervisors)
Transfer Between Funds _____ 4/5's vote		
Contingency _____ 4/5's vote		
() General () Other		

LTC
CLERK'S USE ONLY: *Res. 11-449*
 Res. No.: *11-20* Ord. No. _____
 Vote - Ayes: *4* Noes: _____
 Absent: *[Signature]* Abstained: _____
 Approved
 Minute Order Attached No Action Necessary

COUNTY ADMINISTRATIVE OFFICER:
 Requested Action Recommended
 No Opinion
 Comments:

The foregoing instrument is a correct copy of the original on file in this office.
 Date: _____
 Attest: MARGIE WILLIAMS, Clerk of the Board
 County of Mariposa, State of California
 By: _____
 Deputy

CAO: *[Signature]*

MARIPOSA COUNTY BOARD OF SUPERVISORS RESOLUTION NO. 11-449

A Resolution Approving the Classification of Roadways Within the County of Mariposa

WHEREAS, the Federal Highway Act of 1973 and the Federal Safe, Accountable, Flexible, Efficient, Transportation Equity Act: A Legacy for Users (SAFETEA-LU) requires a classification of all roads and highways in the county; and

WHEREAS, a roadway classification system update for the County of Mariposa has not been previously completed;


WHEREAS, the County of Mariposa has requested classification of roadway segments to two local roads;

WHEREAS, this request is consistent with the approved classification system;

NOW THEREFORE BE IT RESOLVED that the Mariposa County Board of Supervisors does hereby adopt the roadway segments as indicated in the attached Functional Classification Change Request Form.


ON MOTION BY Supervisor Bibby, seconded by Supervisor Stetson, this resolution is duly passed and adopted this 13th day of September, 2011 by the following vote:

AYES: STETSON, BIBBY, CANN, ALLEN
NOES: NONE
EXCUSED: TURPIN
ABSTAIN: NONE




Jim Allen, Chair
Board of Supervisors

ATTEST:

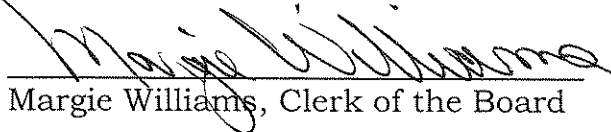

Margie Williams, Clerk of the Board

APPROVED AS TO FORM:

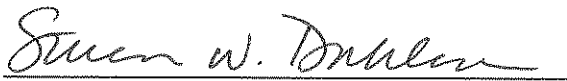

Steven W. Dahlem, County Counsel

Functional Classification Change Request Form


Submitted by: Mariposa County
 Date: September 13, 2011

CRS Map Sheet Number	Coordinate	CT District	County	Jurisdiction	Change/ New/ Delete	Road	From	To	(From) Class	(To) New Class	Length (mi)	Number of Through Lanes	AADT
10M11	D2	10	MPA	Mariposa	Change	Bullion	2nd Street	Jones Street	9	8	0.970	2	1020
10M	D2	10	MPA	Mariposa	Change	Woodland Drive	Hwy 49	To the end	9	8	0.800	2	1553


Click on any column heading for instructions.

Functional Classification Codes	
Rural Functional Class Codes: 01= Principal Arterial Interstate 02=Other Principal Arterial 06=Minor Arterial 07=Major Collector 08=Minor Collector 09=Local	Urban Functional Class Codes: 11=Principal Arterial Interstate 12=Principal Arterial -Other Fwys or Expwys 14=Other Principal Arterial 16=Minor Arterial 17=Collector 19=Local

Woodland Drive
Local Rural
to Minor Collector

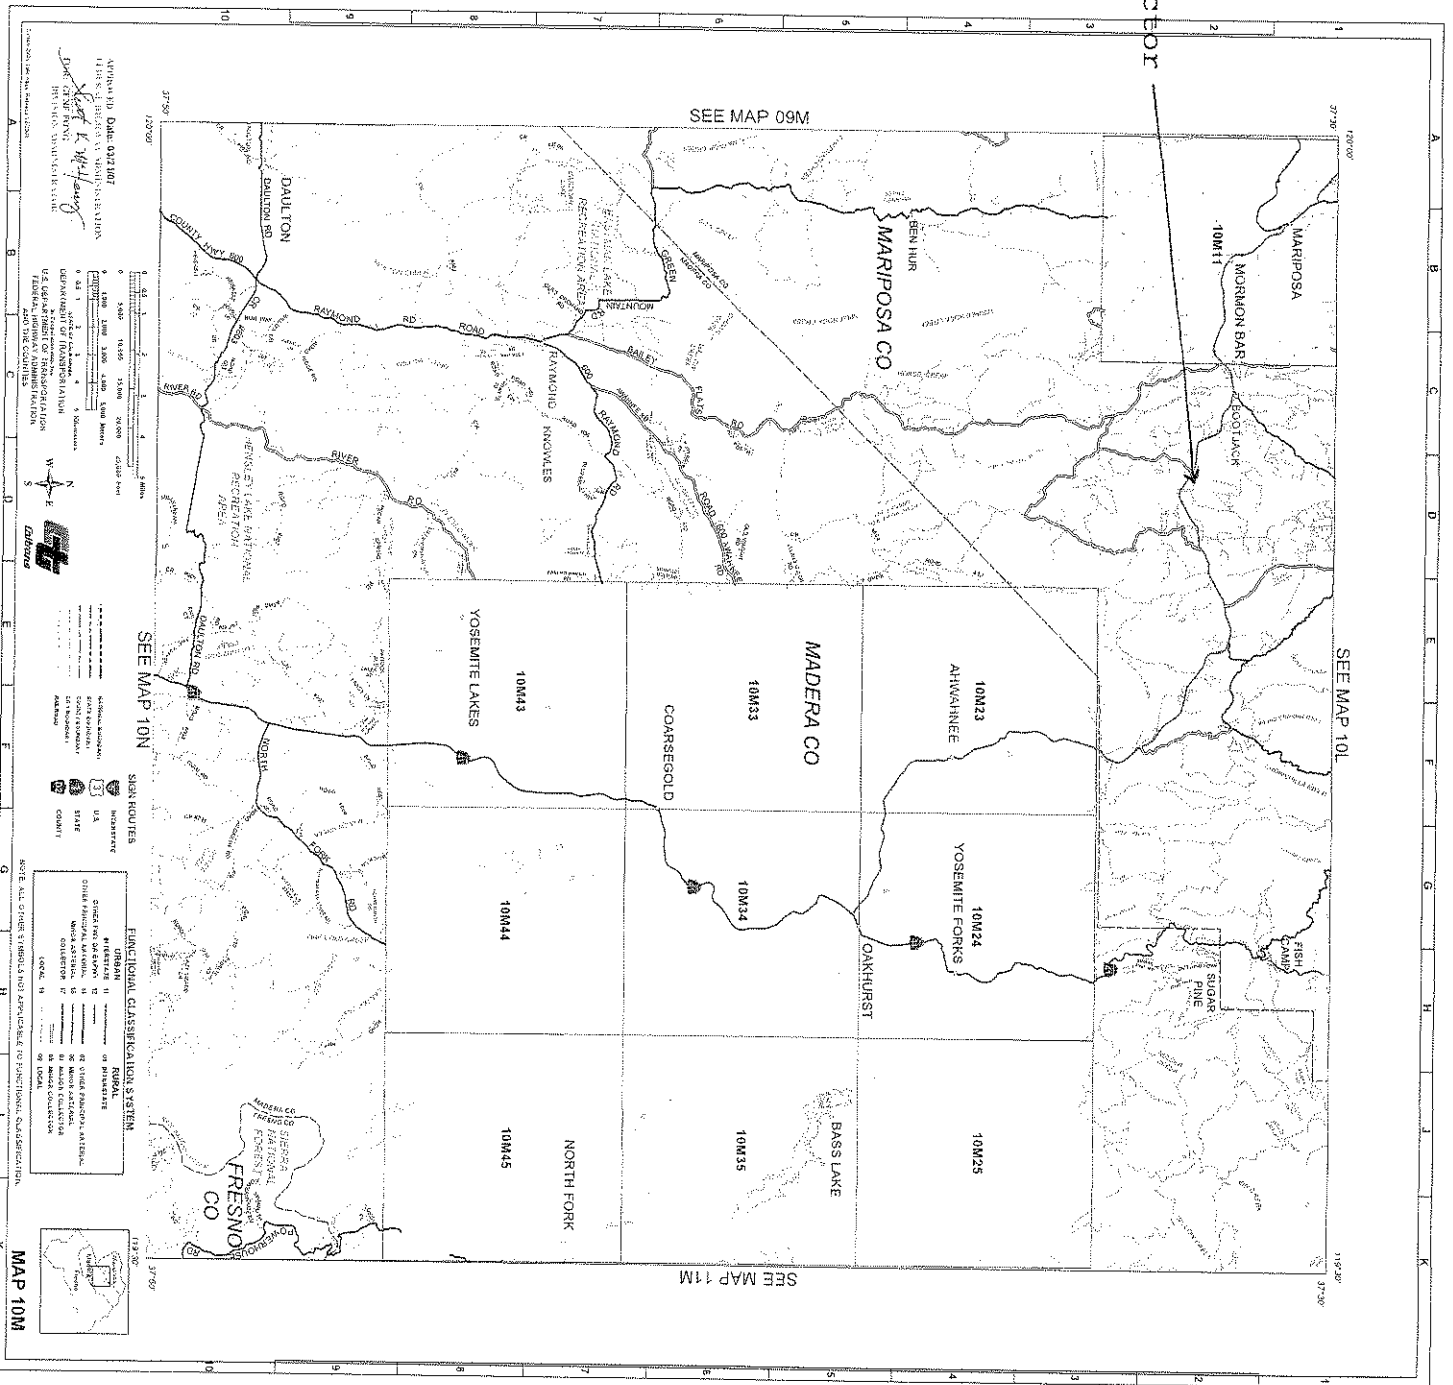

Bullion Street
Local Rural
to Minor Collector

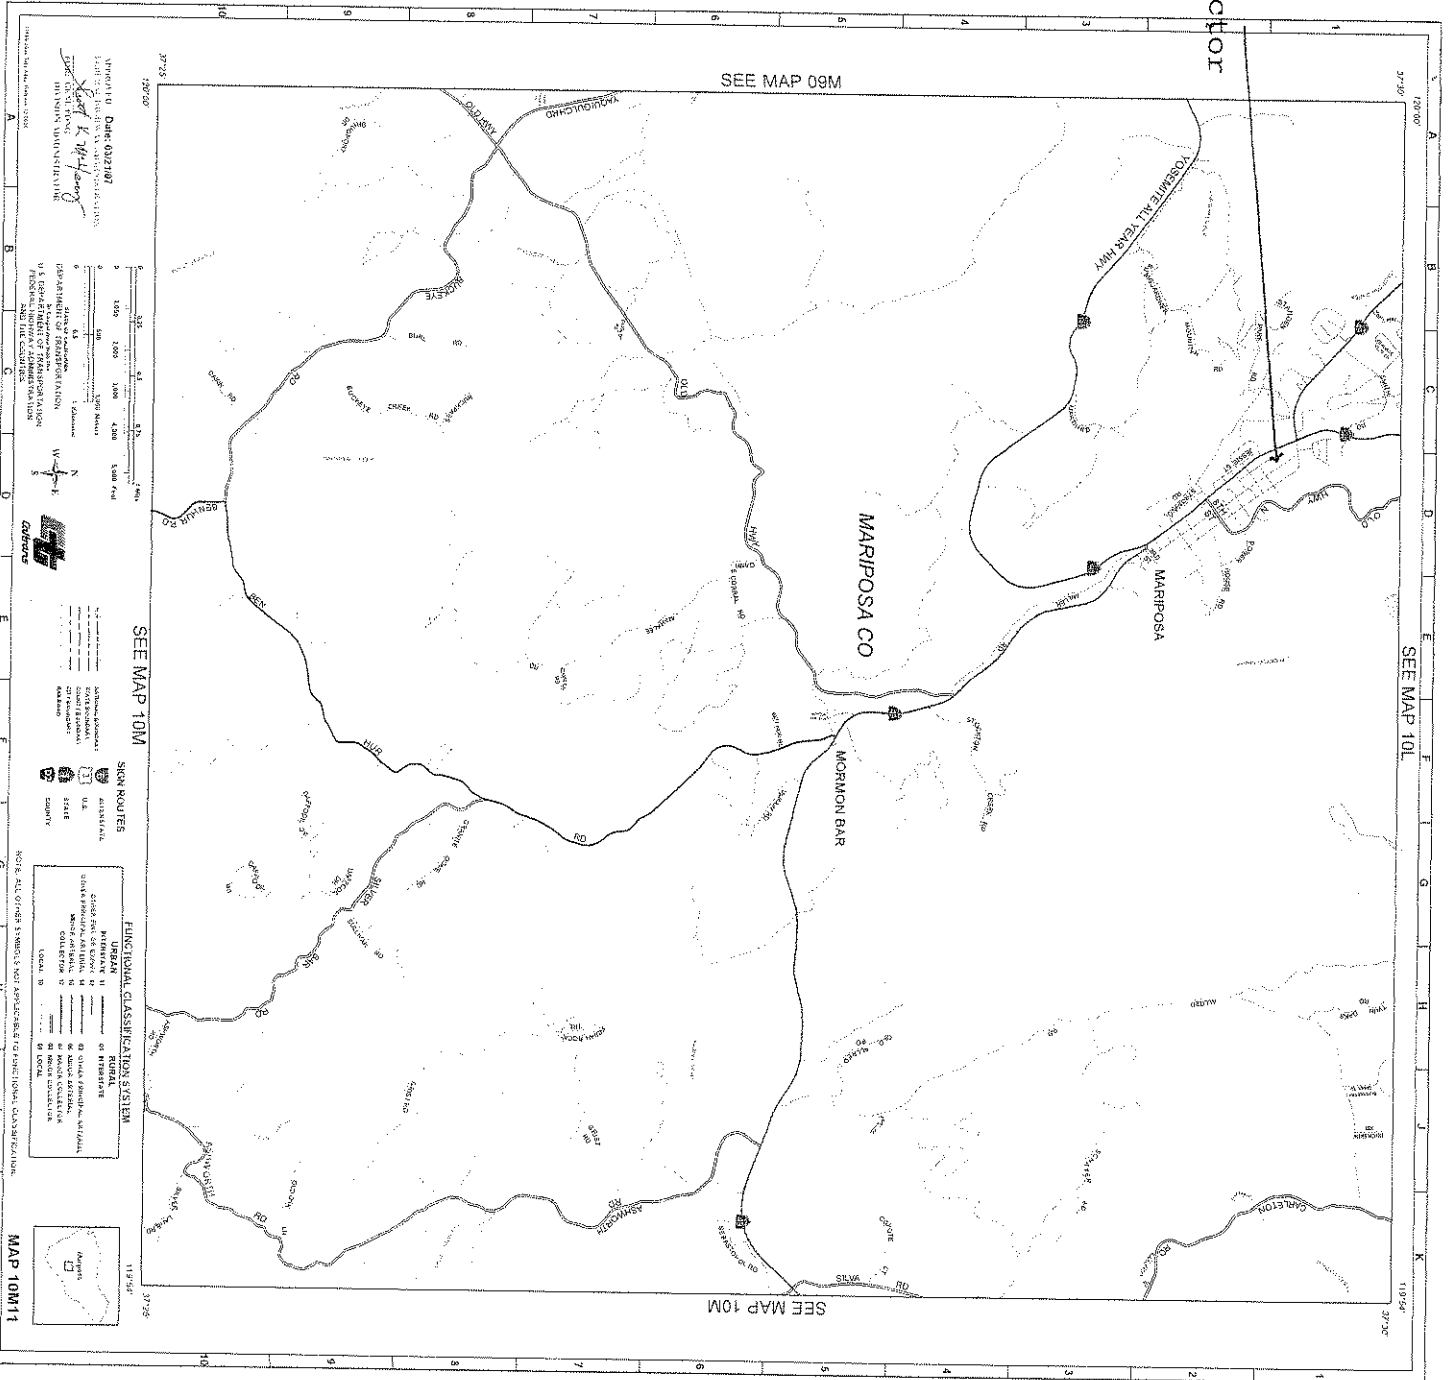

MARIPOSA COUNTY
LOCAL TRANSPORTATION COMMISSION
Resolution Number 11-_____

**A Resolution Approving the Classification of Roadways Within the County
of Mariposa**

WHEREAS, the Federal Highway Act of 1973 and the Federal Safe, Accountable, Flexible, Efficient, Transportation Equity Act: A Legacy for Users (SAFETEA-LU) requires a classification of all roads and highways in the county; and

WHEREAS, a roadway classification system update for the County of Mariposa has not been previously completed;

WHEREAS, the County of Mariposa has requested classification of roadway segments to two local roads;

WHEREAS, this request is consistent with the approved classification system;

NOW THEREFORE BE IT RESOLVED that the Mariposa County Local Transportation Commission does hereby adopt the roadway segments as indicated in the attached Functional Classification Change Request Form.

ON MOTION BY Commissioner _____, seconded by Commissioner _____, this resolution is duly passed and adopted this 13th day of September, 2011 by the following vote:

AYES:
NOES:
EXCUSED:
ABSTAIN:

Lyle Turpin, Chair
Local Transportation Commission

ATTEST:

Margie Williams, Clerk of the Board

APPROVED AS TO FORM:

Steven W. Dahlem, County Counsel

MARIPOSA COUNTY BOARD OF SUPERVISORS RESOLUTION NO. _____

**A Resolution Approving the Classification of Roadways Within the County
of Mariposa**

WHEREAS, the Federal Highway Act of 1973 and the Federal Safe, Accountable, Flexible, Efficient, Transportation Equity Act: A Legacy for Users (SAFETEA-LU) requires a classification of all roads and highways in the county; and

WHEREAS, a roadway classification system update for the County of Mariposa has not been previously completed;

WHEREAS, the County of Mariposa has requested classification of roadway segments to two local roads;

WHEREAS, this request is consistent with the approved classification system;

NOW THEREFORE BE IT RESOLVED that the Mariposa County Board of Supervisors does hereby adopt the roadway segments as indicated in the attached Functional Classification Change Request Form.

ON MOTION BY Supervisor, _____ seconded by
Supervisor, _____ this resolution is duly passed and
adopted this 13th day of September, 2011 by the following vote:

AYES:

NOES:

EXCUSED:

ABSTAIN:

Jim Allen, Chair
Board of Supervisors

ATTEST:

Margie Williams, Clerk of the Board

APPROVED AS TO FORM:

Steven W. Dahlem, County Counsel

(3)